

Sheet 1-A


STATE OF NEW YORK
PUBLIC SERVICE COMMISSION
FOR THE FIRST DISTRICT
ENGINEERING DEPT. - SEWER DIVISION

RECORD DRAWING OF SEWERS
CHURCH ST. CORTLANDT ST. TO DEY ST.
ROUTE NO. 5 SECTION NO. 1

DWG. NO. **R.457**
FILE NO. **E.I.**

DATE *June 15 1908*
DRAWN BY *E. J. [illegible]*
CHECKED BY *[illegible]*

CHIEF ENGINEER

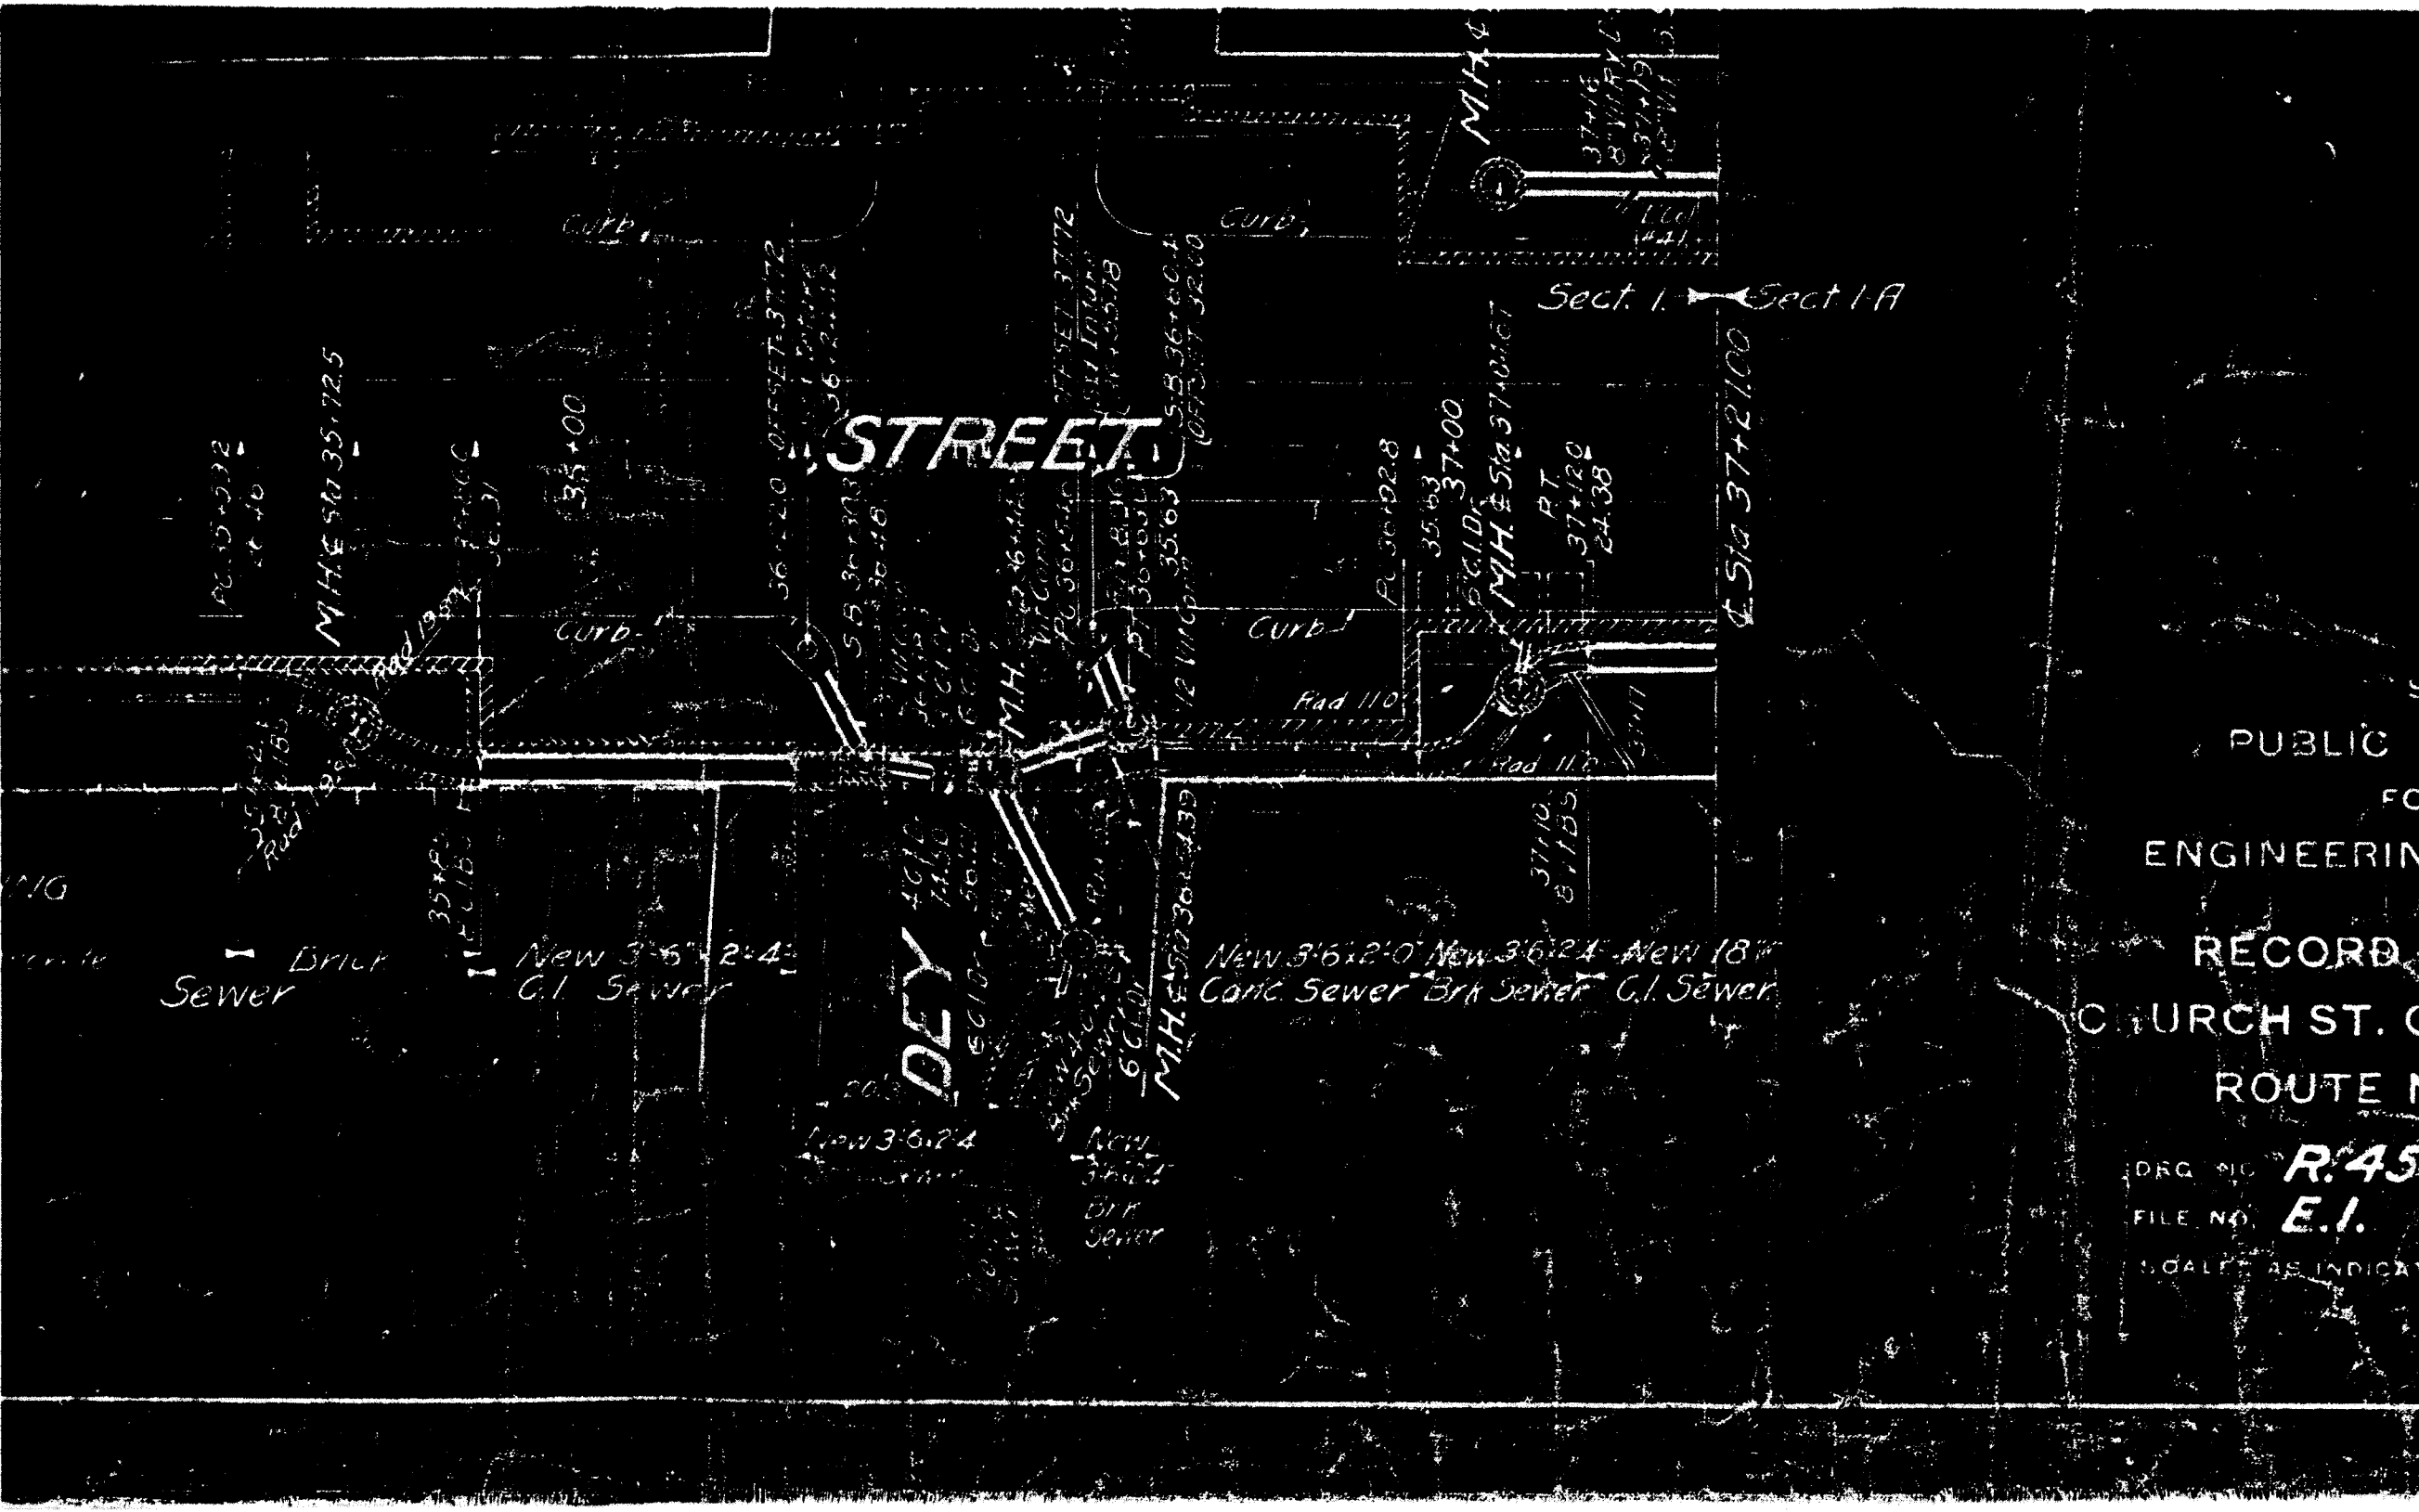

PUBLIC
FOR
ENGINEERING

RECORD
CHURCH ST. C
ROUTE N

DRG. NO. **R. 45**
FILE NO. **E. 1.**
SCALE AS INDICAT

FILE WEST SIDE.



FILE EAST SIDE.

