

02/12/99 13:51 FAX 2122190256

SWANKE HAYDEN CONNELL

001/003

**SWANKE HAYDEN CONNELL ARCHITECTS****Fax Message****To:** Rebecca Niemkamper  
ICF/ Niemkamper Group**From:** Joshua J. Ginsburg**Fax:** 212.260.8171**Job:** 5576 A**Date:** February 12, 1999 **Pages:** 3**Message:**

Rebecca,

Please provide OEM with a proposal for the following alterations to the Mayor's conference table at 7 World Trade Center. Please note that all modifications to the existing table must be performed on site. OEM has requested 3 additional Forum plates. Each plate shall contain 12 Data/ Voice cutouts (see enclosed sketches for location). Please send your proposal directly to John Hughes of the Mayor's Office of Emergency Management at 7 World Trade Center, 23<sup>rd</sup> Floor. We would appreciate that this proposal be given priority, as OEM would like to make the revision ASAP. Please contact me regarding the lead time for the above mentioned items.

If you have any questions, please give me a call.

Thank you,

Joshua J. Ginsburg  
212.219.6674

Cc: Glen Pymonto (DCAS) 212.669.3640  
John Hughes (OEM) 212.442.8885  
Joe Aliotta (SHCA)  
John Vande Plasse (SHCA)

\\NEWYORK04\PROJECTS\5576\A\OEMDocs\Fax\Niemkamper.99.02.12.new.plates.doc

Swanke Hayden Connell Ltd./Swanke Hayden Connell & Partners LLP  
295 Lafayette Street, New York, New York 10012  
212 226 9696, Fax 212 219 0059

02/12/99 13:52 FAX 2122190256

SWANKE HAYDEN CONNELL


002/003

12/01/98 13:28 4162989535

NIENKAMPER

ICF NY

002/005

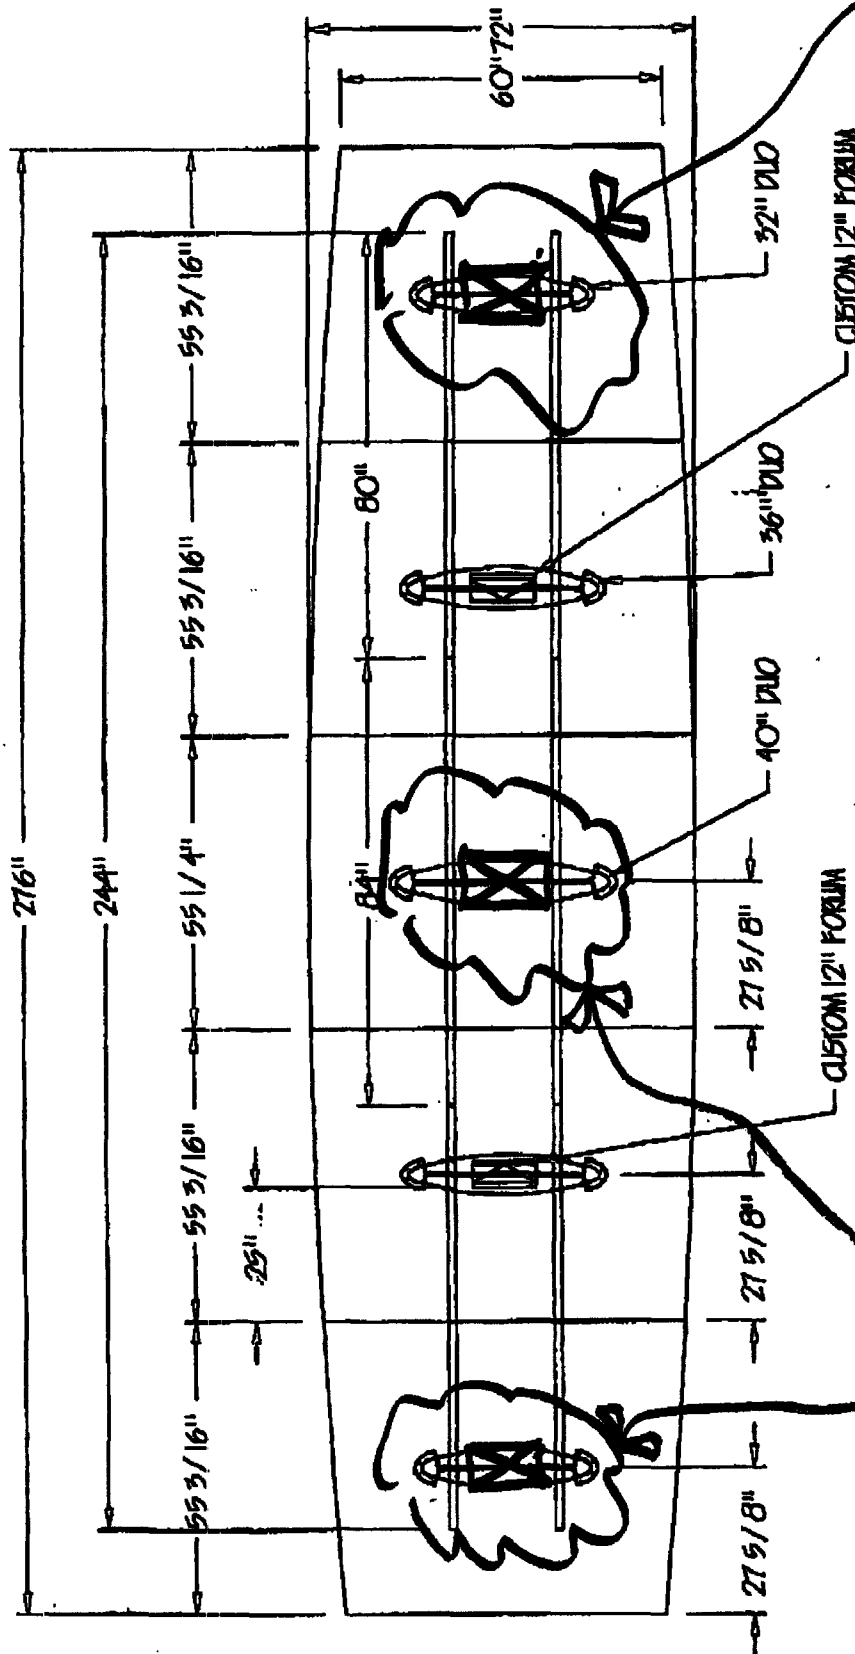

NEW CUSTOM FORUM, 12 DATA/VOICE -  
CUT-OUTS PER RATE, INSTALLED  
IN FIELD (3 NEW FORUMS TOTAL -  
36 DATA/VOICE JACKS)

REVISED OCT. 27/98 BY P.B.  
FROM QUOTE 0980066

|                                       |                                                                                                         |                                                                      |                                         |
|---------------------------------------|---------------------------------------------------------------------------------------------------------|----------------------------------------------------------------------|-----------------------------------------|
| <b>ICF group</b><br><b>nienkämper</b> | 257 Finchdene Square<br>Scarborough, Ontario,<br>Canada M1X 1B9<br>Tel 416-298-8700<br>Fax 416-298-4428 | Project: OC# 9020 BPI<br>Scale: 3/8" = 1'0"<br>Drawn By: P. BEALPANT | Drawing No: 98.722.0<br>Date: OCT. 5/98 |
|---------------------------------------|---------------------------------------------------------------------------------------------------------|----------------------------------------------------------------------|-----------------------------------------|

