

01/19/99 15:23 FAX 2122190256

SWANKE HAYDEN CONNELL

001/003


SWANKE HAYDEN CONNELL ARCHITECTS

Fax Message

Attention	Martin Schneider	From	Juan M. Mejia
To	AMBASSADOR CONSTRUCTION CO. INC.	Job Name	OEM
Address	317 Madison Avenue	Job No	5576A
	New York, New York 10017	Phone	212 922-1020
		Fax	212 949-9762
Copy:	SEE BELOW	Date	1/19/99
		Time	2:47:02 PM
		Page	3
		Quantity	

Re: PRESS ROOM REVISION & PERIMETR DETAIL @ PROTECTIVE WALL.


- ATTA CHED PLEASE FIND FSK-55 FOR ADDIND A PLATFORM AT THE PRESS ROOM FOR THE MAYOR AT +8" ABOVE EXISTING RAISED FLORR AS PER GLENN PYMENTO INSTRUCTIONS, AND REVISED DETAIL FOR SEALING THE GAP AT THE PROTECTIVEV WALL AT THE PERIMETER.
- PLEASE PROVIDE PRICING AND SCHEDULE FOR INSTALLATION TO GLENN PYMENTO AS SOON AS POSSIBLE.
- CC: Glenn Pymeto / DCAS / 669-3640, John Hughes / OEM / 442-8885

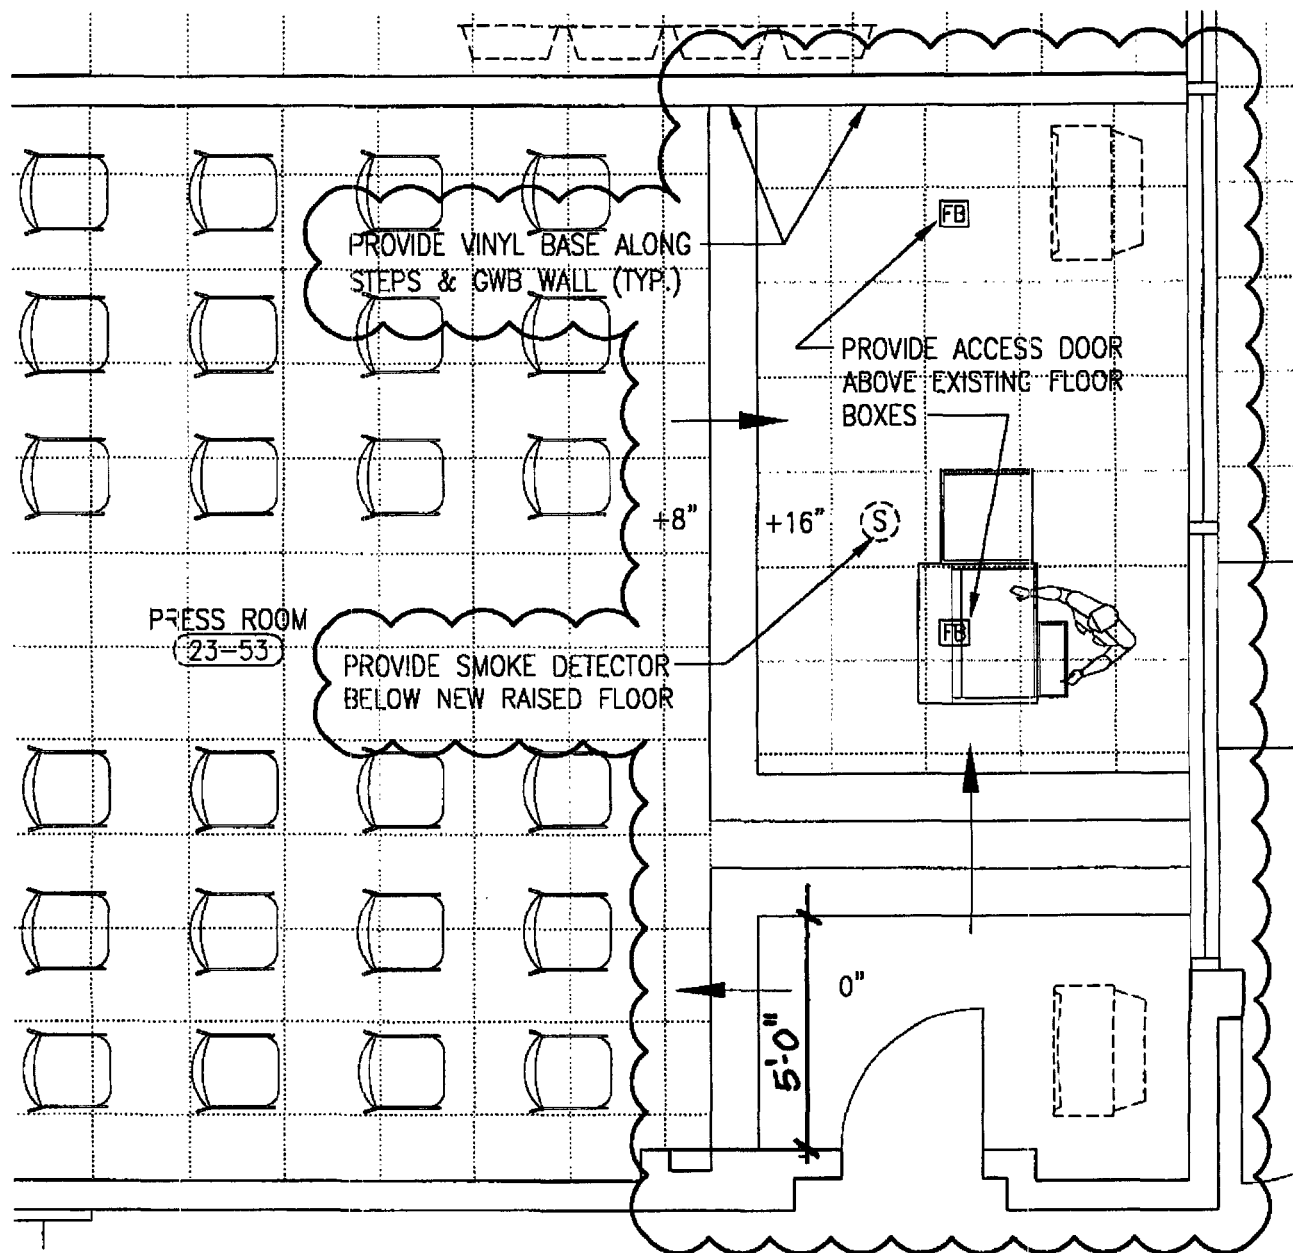SWANKE HAYDEN CONNELL ARCHITECTS

No.	Date	Revisions	Job Title	Scale	Sketch Number
			Mayor's Office of Emergency Management	1/4" = 1'-0"	
			Drawing Title	Drawn By	
			Press Room Podium	JG	SK-55
				Issued	Job No.
				01/19/99	5576 A
				© 1999 Swanke Hayden Connell Architects	

Swanke Hayden Connell Ltd.
 Swanke Hayden Connell & Partners, LLP
 295 Lafayette Street, New York, New York 10012
 Phone 212 226 9898, Fax 212 219 0059

SWANKE HAYDEN CONNELL ARCHITECTS

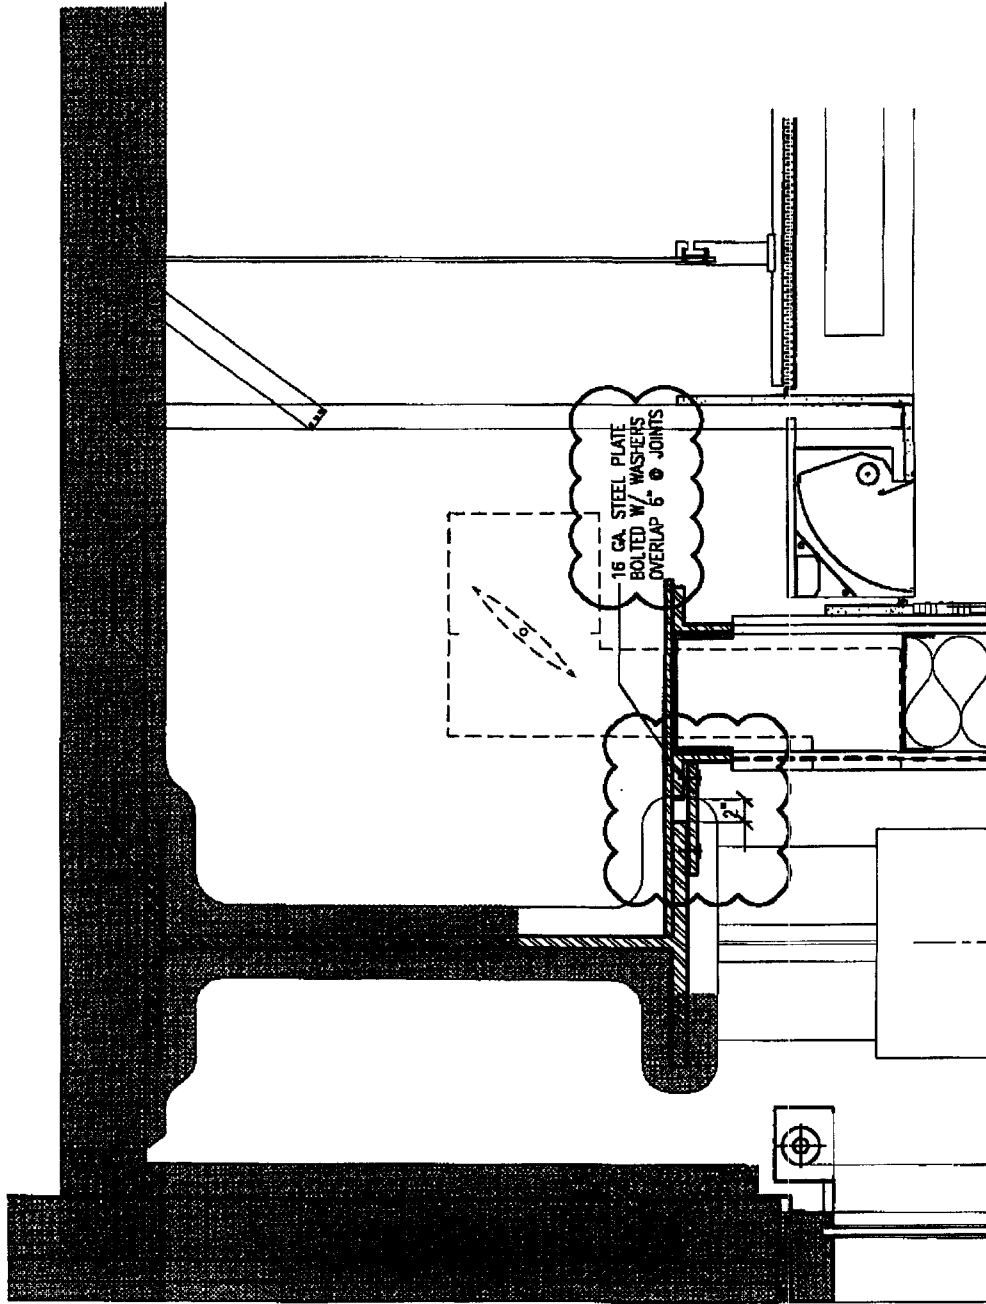

No. 1012 Revisions

NO.	DATE	REVISIONS
1	01-19-99	ISSUED FOR PERMIT
2	01-19-99	ISSUED FOR PERMIT
3	01-19-99	ISSUED FOR PERMIT
4	01-19-99	ISSUED FOR PERMIT
5	01-19-99	ISSUED FOR PERMIT
6	01-19-99	ISSUED FOR PERMIT
7	01-19-99	ISSUED FOR PERMIT
8	01-19-99	ISSUED FOR PERMIT
9	01-19-99	ISSUED FOR PERMIT
10	01-19-99	ISSUED FOR PERMIT

Job Title/Drawing Title

MANHATTAN OFFICE OF EMERGENCY MANAGEMENT

SECTION DETAIL OF PERIMETER PROTECTIVE WALL

Swanke Hayden Connell Ltd
205 Lafayette St., New York, New York 10012
(212) 693-8888 FAX: (212) 693-8889

Scale
1 1/2" = 1'-0" PSK-54
Drawn By

Issued
01-19-99
Job No. 5578A
© 1999 Swanke Hayden Connell Architects