NYC 9/11 Public Portal Document

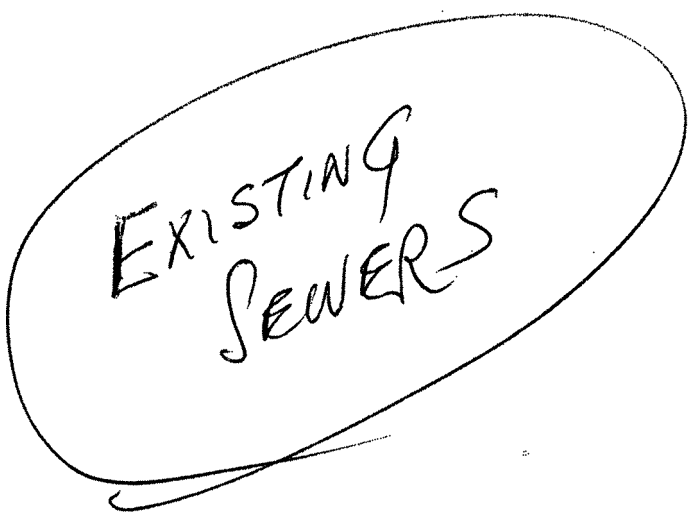

NYC-WTC_000165488

RIVER

NORTH

49TH ST.

48TH ST.

47TH ST.

46TH ST.

45TH ST.

44TH ST.

AVE.

TWELFTH

ELEVENTH

PIERHEAD

BULKHEAD

LINE

TWIN 4'0"x5'0" F.T.R.C. SANITARY

TWIN 6'0"x12'0" F.T.R.C. STORM SEWER

560' 4'0"x9'0" F.T.R.C. SANITARY 1932

4'0"x9'0" F.T.R.C. 1932

4'0"x9'0" F.T.R.C. SEWER 1932

4'0"x2'8" ELL

4'0"x2'8" EGG

12" TEMPORARY SANITARY BY-PASS

SANITARY DAM
(TEMPORARY SANITARY BY-PASS
60 VCP PASSES UNDER 4'0"x9'0"
NO CONNECTION BETWEEN THESE SEWERS

4'0"x3'8" PASSES UNDER 4'0"x9'0"
NO CONNECTION BETWEEN THESE SEWERS

SANITARY DAM

4'0" CIR. CONCRETE SANITARY 1919

DOUBLE 6'8"x5'6" CONC. STORM 1919

4'0" CIRCULAR WOODEN BARREL SANITARY 1919

4'6" CIR. BARREL D.P.W. 1928

54" CIR. 1929 DEPT. OF DOCKS

4'0" R.C. 1928 D.P.W.

Replaced by Special 4'0"x2'-4" Sewer (See Intercepter Drawings)

ABANDONED PARTIALLY (See Intercepter Drawings)

OVERFLOW TO STORM SEWER

GAS CHAMBER

TRANSITION STRUCTURE

TWIN 7'6"x7'6"

4'0"x2'8" ELL

MANHATTAN SEWERS SHEET B14

(See Manhattan Sewers Sheet 3 of 8 for INVERTS
& North River I/I Sheet 6

See North River Intercepter Drawings Sheet-16 for Current Arrangement at W46 St (DA 8'6"x8'6" was partially abandoned) & 3'x5' Sewer Replaced by 4'0"x2'-4" Sewer)

See North River Intercepter Drawings Sheets 61-63 for Regulator 36 @ W46 St Pier 86

NYC 911 Public Portal Document

NYCWTC-0001654B9

NYC 9/11 Public Portal Document

MANHATTAN Sewers
SHEET No. 3 of 8
Revised Jan 20-1948
Revised May 1, 1946
Revised Dec 31, 1924
Revised Dec 31, 1926

9TH AVE.
10TH AVE.
11TH AVE.
12TH AVE.

NORTH RIVER

19TH ST.
20TH ST.
21ST ST.
22ND ST.
23RD ST.
24TH ST.
25TH ST.
26TH ST.
27TH ST.
28TH ST.
29TH ST.
30TH ST.
31ST ST.
32ND ST.
33RD ST.
34TH ST.
35TH ST.
36TH ST.
37TH ST.
38TH ST.
39TH ST.
40TH ST.
41ST ST.
42ND ST.
43RD ST.
44TH ST.
45TH ST.
46TH ST.
47TH ST.
48TH ST.

PUBLIC PARK
ALEX HAMILTON PARK
ELLIOT HOUSES
ELLIOT HOUSES

NYC:WTC_000165490

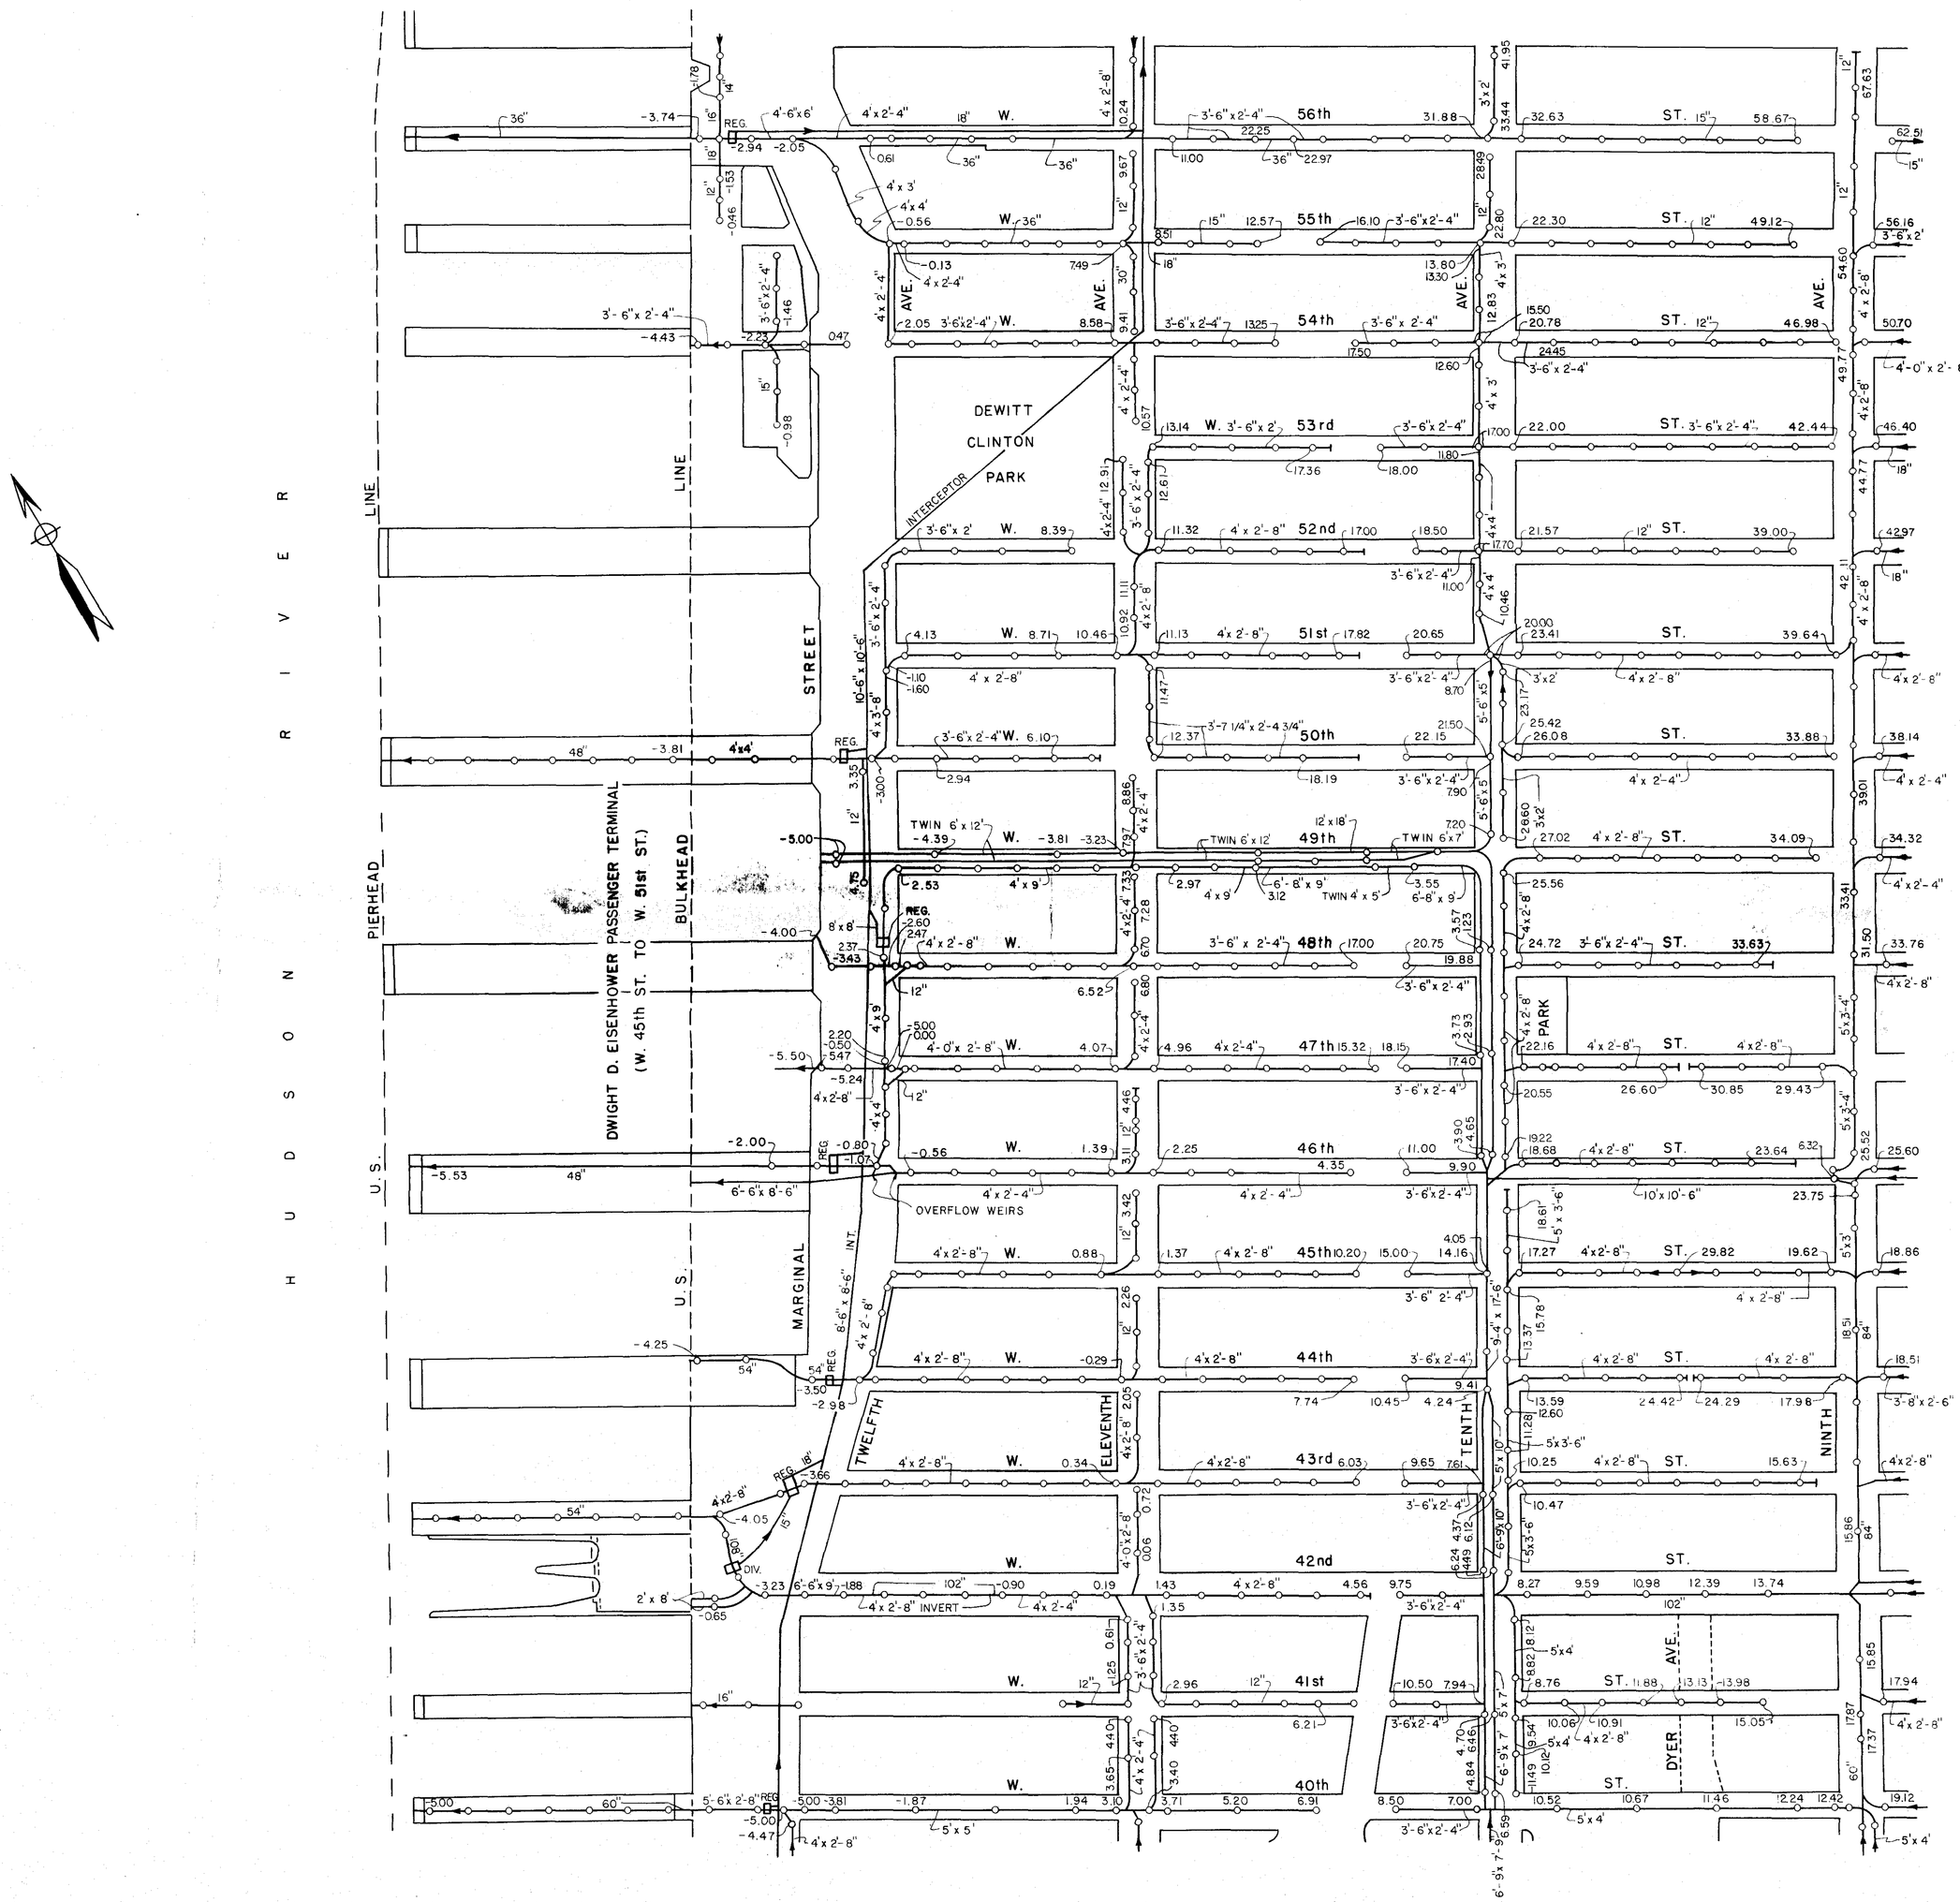

 

NO.	DATE	DESCRIPTIONS	APPR'D

THE CITY OF NEW YORK
ENVIRONMENTAL PROTECTION ADMINISTRATION
DEPARTMENT OF WATER RESOURCES
BUREAU OF WATER POLLUTION CONTROL

SCALE IN FEET
200 100 0 200 400

NORTH RIVER W.P.C.P.
W.P. 164
BOROUGH OF MANHATTAN

INFILTRATION / INFLOW ANALYSIS
APPENDIX A
EXISTING SEWER SYSTEM

DATE
1-78

SHEET 6
OF 18

30" x 40"

NYC 911 Public Portal Document

NYCAVTC_00016491

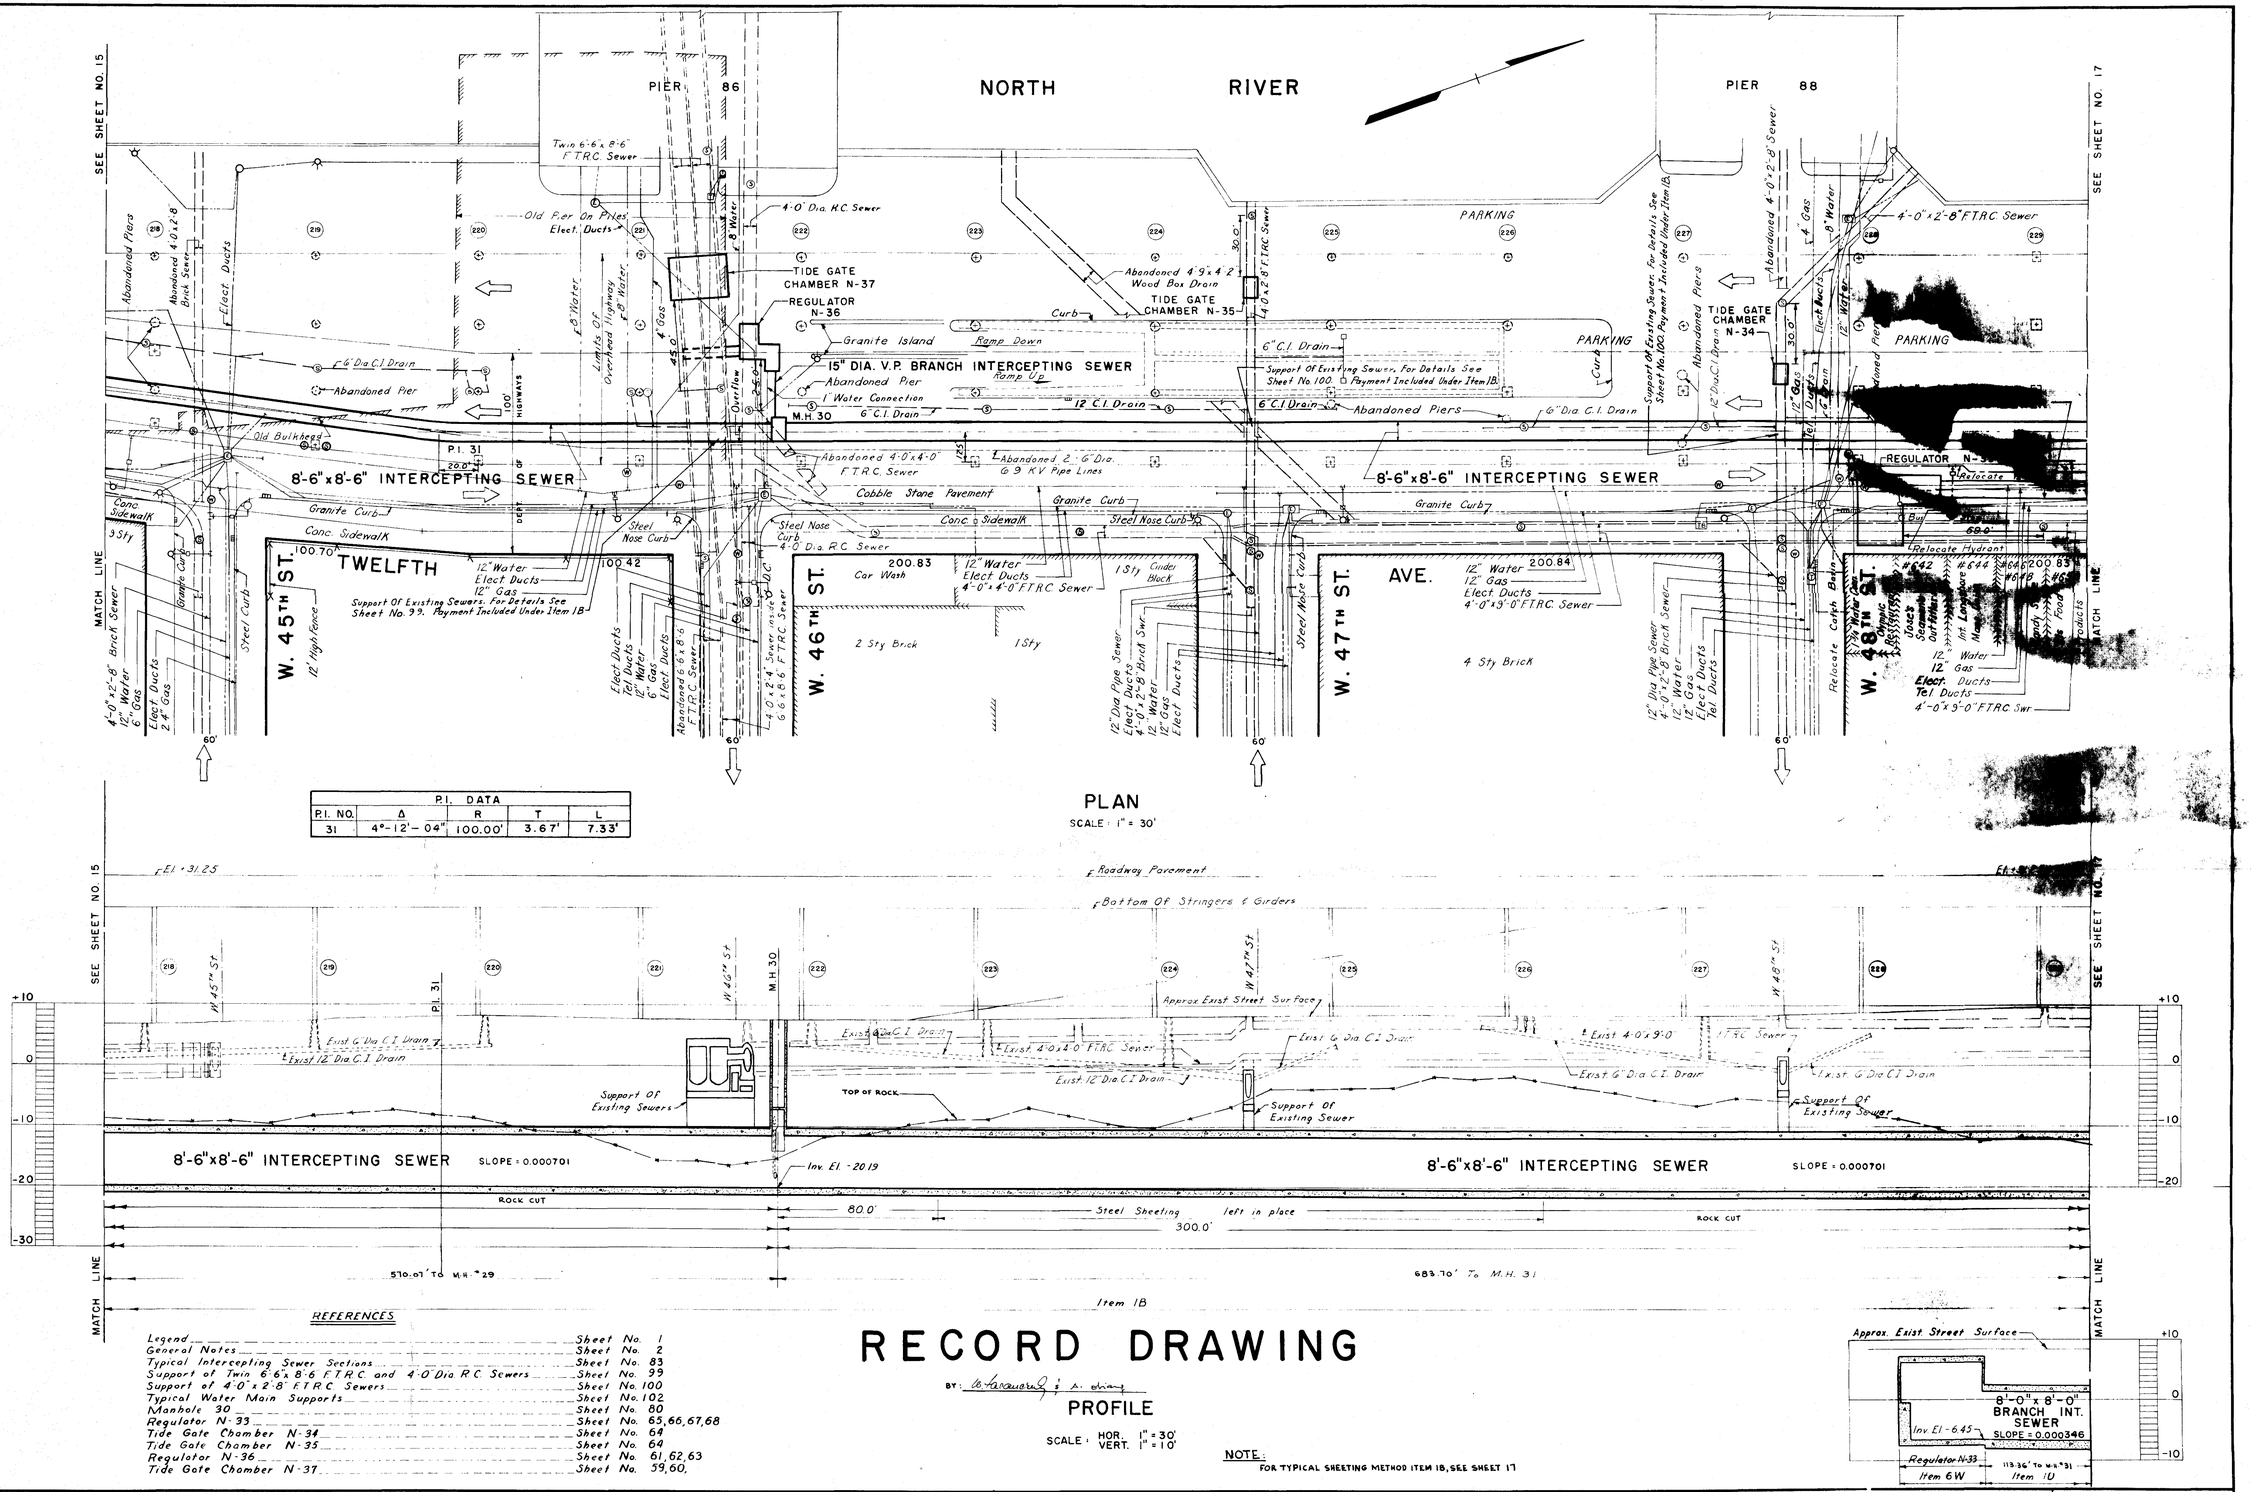

PLAN

SCALE : 1" = 30'

P.I. DATA				
P.I. NO.	Δ	R	T	L
31	4°-12'-04"	100.00'	3.67'	7.33'

REFERENCES

Legend	Sheet No. 1
General Notes	Sheet No. 2
Typical Intercepting Sewer Sections	Sheet No. 83
Support of Twin 6'-6" x 8'-6" F.T.R.C. and 4'-0" Dia. R.C. Sewers	Sheet No. 99
Support of 4'-0" x 2'-8" F.T.R.C. Sewers	Sheet No. 100
Typical Water Main Supports	Sheet No. 102
Manhole 30	Sheet No. 80
Regulator N-33	Sheet No. 65, 66, 67, 68
Tide Gate Chamber N-34	Sheet No. 64
Tide Gate Chamber N-35	Sheet No. 64
Regulator N-36	Sheet No. 61, 62, 63
Tide Gate Chamber N-37	Sheet No. 59, 60,

RECORD DRAWING


PROFILE

SCALE : HOR. 1" = 30'
VERT. 1" = 10'

NOTE: FOR TYPICAL SHEETING METHOD ITEM 1B, SEE SHEET 17

NO.	DATE	DESCRIPTION	APPR'D.
		REVISIONS	

DR. Innaurato TR. B. Hoover
CK. DES.
Martin J. Gelfman P.E. GROUP LEADER
I. Sidney Ports P.E. SEWER ENGINEER

SCALE AS SHOWN

CONSTRUCTION SUPERVISION
MATHEWS AND CHASE
Jon Cooksey for P.E.
RESIDENT ENGINEER

Herman Sanetti P.E. CHIEF OF SECTION
S. D. Brown P.E. 7-1-68 PROJECT ENGINEER
Frank Santelli P.E. 7-1-68 CHIEF OF BUREAU

CITY OF NEW YORK
BUREAU OF WATER POLLUTION CONTROL
DIVISION OF PLANT DESIGN
P.W. 164 NORTH RIVER WATER POLLUTION CONTROL PROJECT

CONTRACT NO. 1
SOUTH BRANCH INTERCEPTING SEWER - BANK ST. TO W. 50TH ST.
TWELFTH AVE. - W. 45TH ST. TO W. 49TH ST.
PLAN AND PROFILE

DATE
SHEET 16 OF 107

NYC 911 Public Portal Document
NYC-WTC_0001654-2
HOWARD-SUTTON CO., INC., N.Y.C. — IMPERIAL

REFERENCES

Legend	Sheet No.	1
General Notes	Sheet No.	2
Plan and Profile	Sheet No.	16
Typical Intercepting Sewer Sections	Sheet No.	83
Support of Twin 6'-6" x 8'-6" F.T. and 4'-0" Dia. R.C. Sewers	Sheet No.	99
Typical Water Main Supports	Sheet No.	102
Manhole 90	Sheet No.	80
Tide Gate Chamber N-37	Sheet No.	59,60
Typical Granite and Concrete Details	Sheet No.	103
Sluice Gate Arrangement	Sheet No.	104
Tide Gate Arrangement and Details	Sheet No.	105
Typical Concrete Details	Sheet No.	106
Miscellaneous Castings and Details	Sheet No.	107

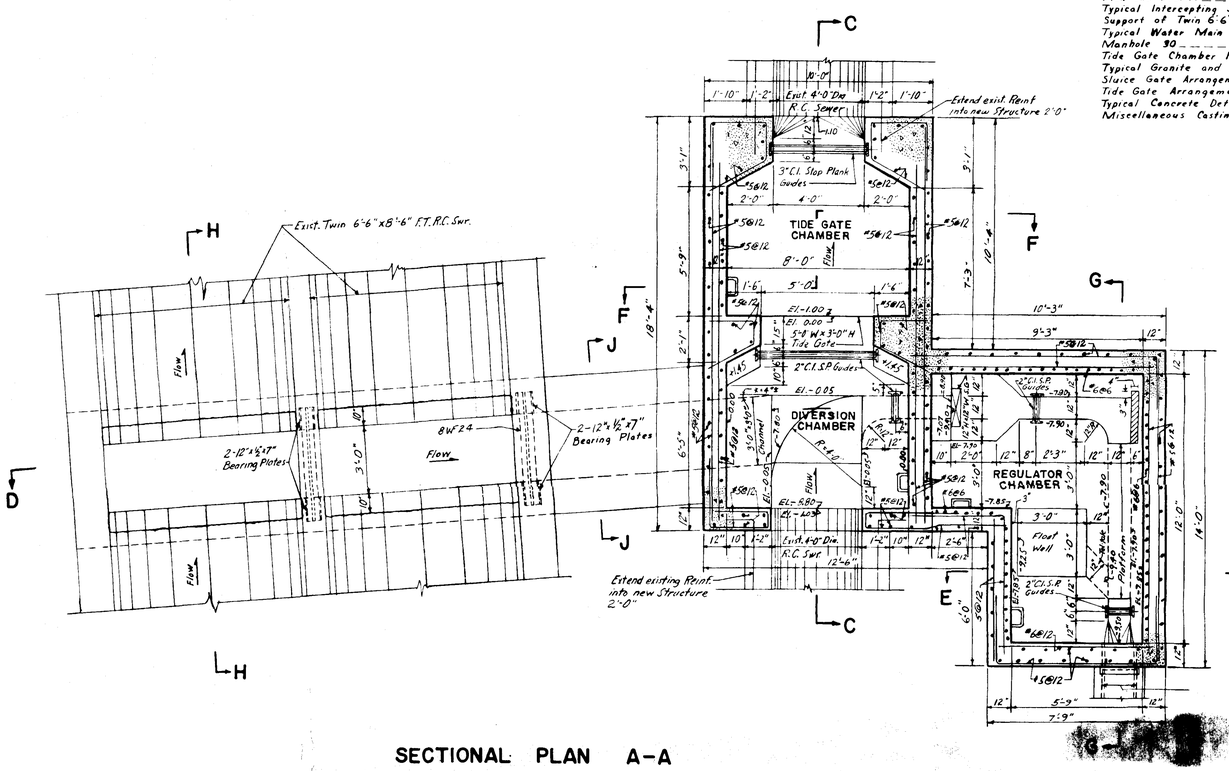

SECTIONAL PLAN A-A

 

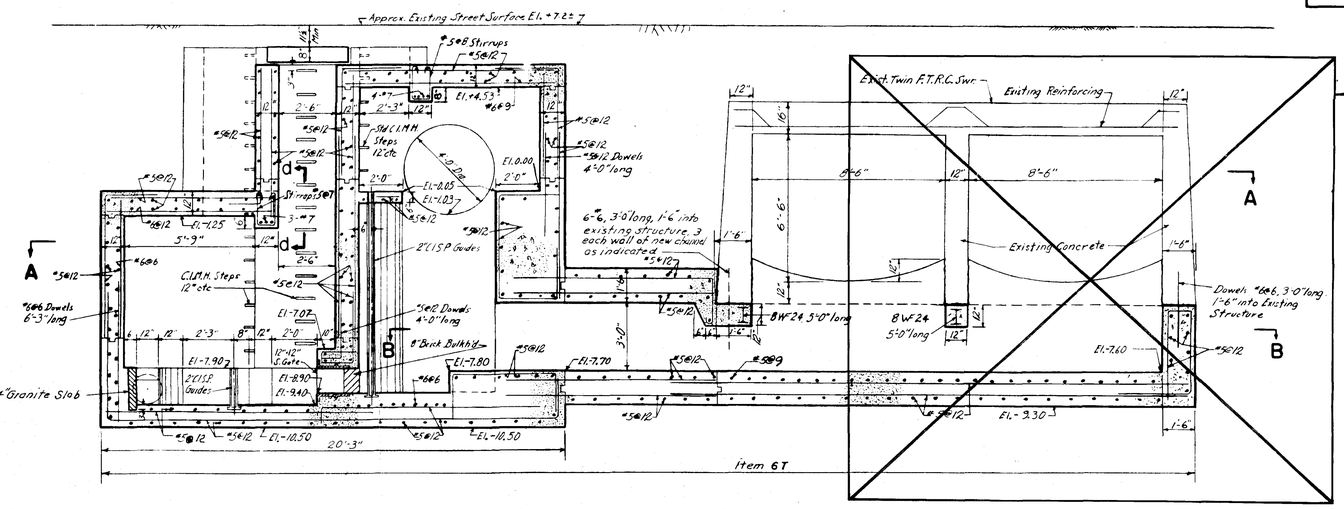

SECTION D-D

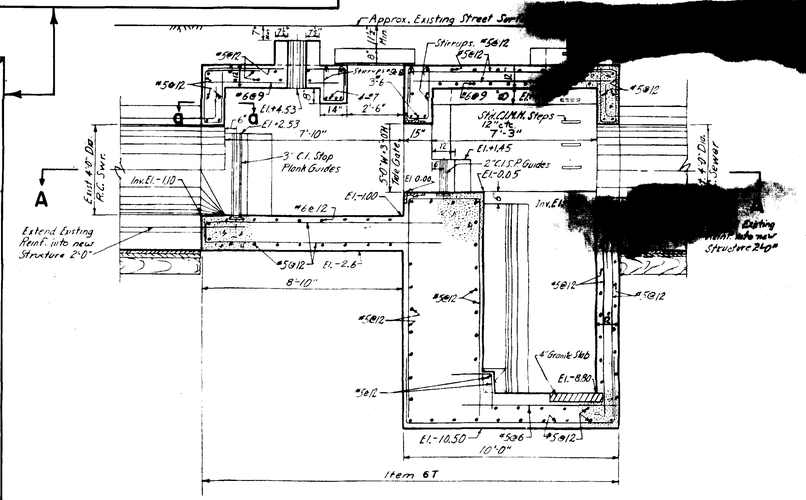

SECTION C-C

RECORD DRAWING

BY: L. Wagner & L. Wang

NO.	DATE	DESCRIPTION	APPR'D.
		REVISIONS	

DR. A. Gaetano TR.
CK. H. Putter DES. A. Gaetano
Master of Mech. Group Leader
Herbert J. Putter P.E. Sewer Engineer

SCALE 3/8"= 1'-0" AND AS SHOWN

CONSTRUCTION SUPERVISION
MATHEWS AND CHASE
Jim Cobbington, P.E. Resident Engineer

Herman J. Smith P.E. Chief of Section
E. J. Moran P.E. 7/1/68 Project Engineer
Frank Santilli P.E. 7-1-68 Chief of Division

CITY OF NEW YORK
BUREAU OF WATER POLLUTION CONTROL
DIVISION OF PLANT DESIGN
P.W. 164 NORTH RIVER WATER POLLUTION CONTROL PROJECT

CONTRACT NO. 1
SOUTH BRANCH INTERCEPTING SEWER-BANK ST. TO W. 50TH ST.
REGULATOR N-36 TWELFTH AVE. AT W. 46TH ST.
PLANS AND SECTIONS

DATE

SHEET 61 OF 107

27" x 40"

NYC 911 Public Portal Document
NYC-WTC_0001165493

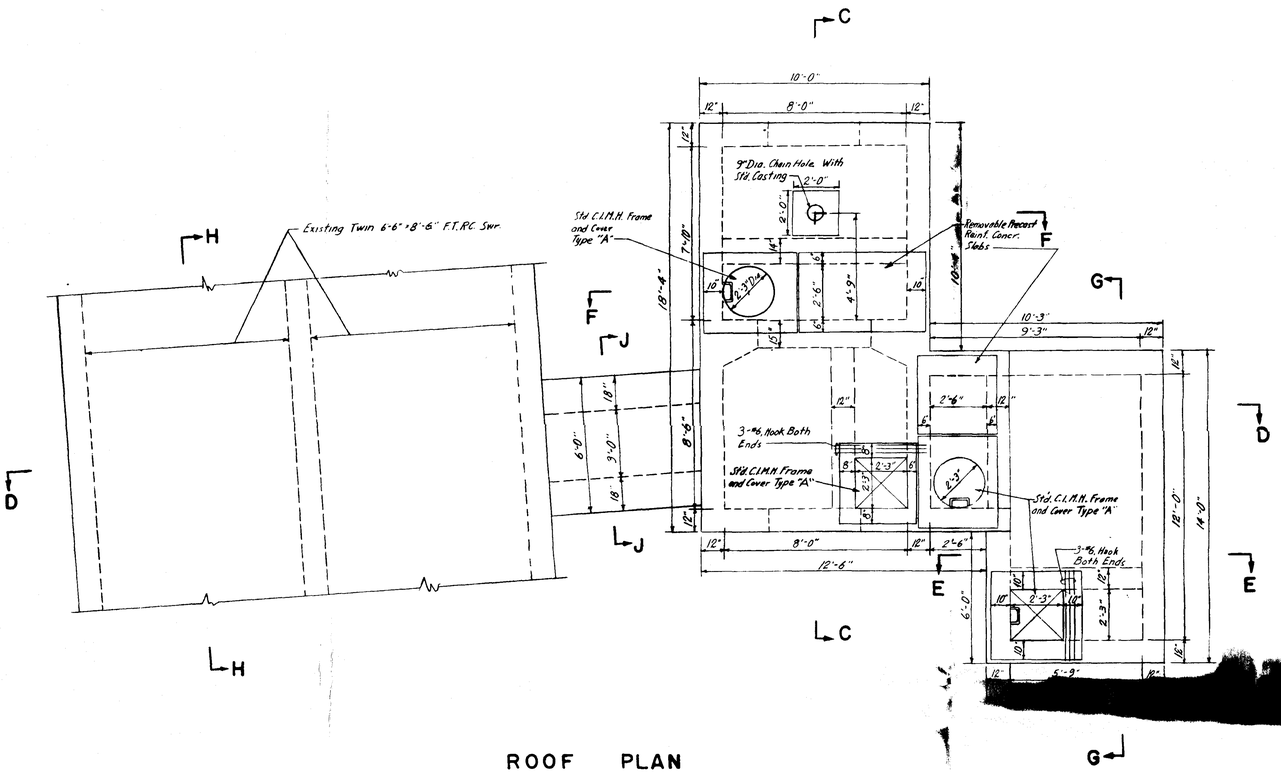

ROOF PLAN

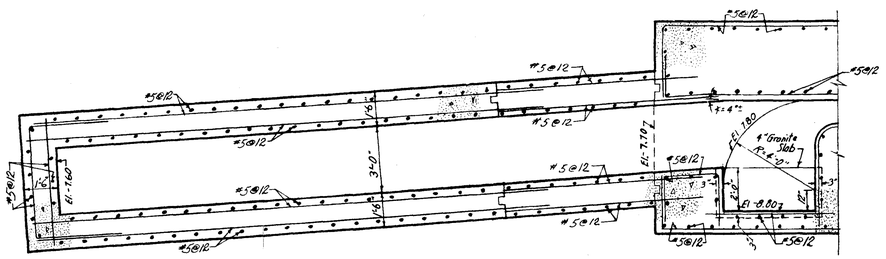

SECTIONAL PLAN B-B

 
Approx. Exist. Street Surface El. +7.2 ±
C
#5@12
#5@6 Stirrups
#5@12

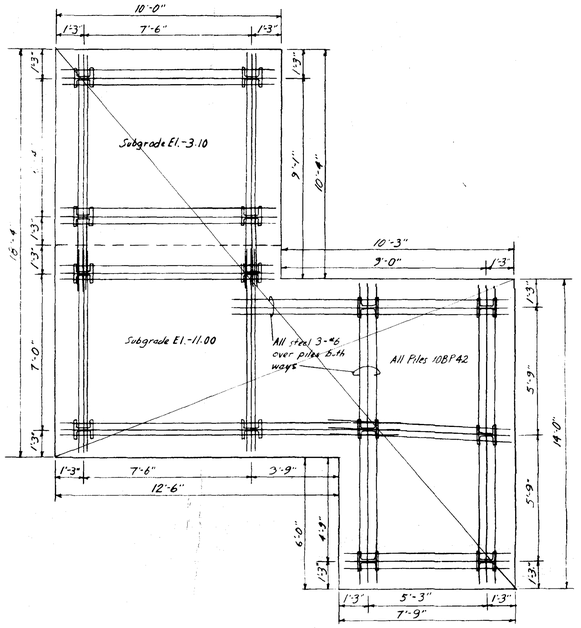

PILE PLAN (IF REQUIRED)

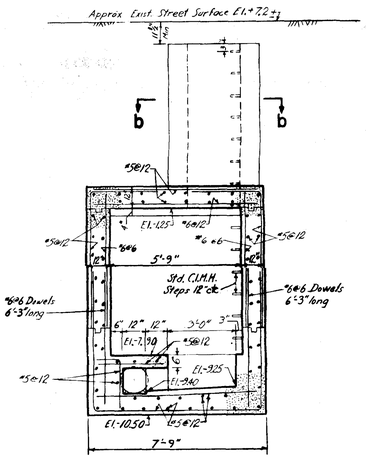

SECTION E-E

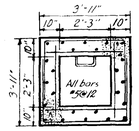

SECTION b-b

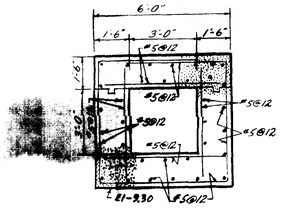

SECTION J-J

 

SECTION d-d

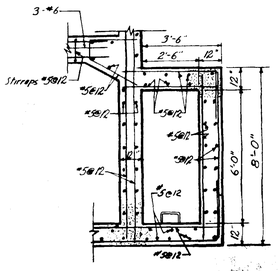

SECTION c

 

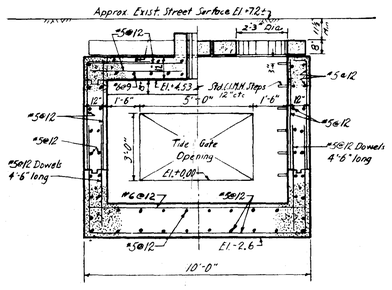

SECTION F-F

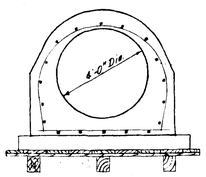

EXISTING 4'-0" DIA. R.C. SEWER

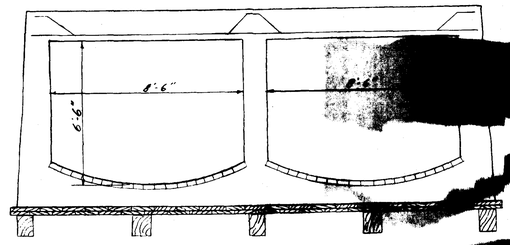

EXISTING TWIN 6'-6" x 8'-6" F.T.R.C. SEWER

RECORD DRAWING

BY: Lo Iacovelli & Adams

NO.	DATE	DESCRIPTION	APPR'D.
		REVISIONS	

DR. M. GELFAND TR.
C'K'D H. PUTTER DES'T GELFAND
Martin J. Gelfand P.E.
GROUP LEADER
Herbert Putter P.E.
SEWER ENGINEER

SCALE 3/8" = 1'-0"

CONSTRUCTION SUPERVISION
MATHEWS AND CHASE
Jm. Cushington P.E.
RESIDENT ENGINEER

Herman J. Smith P.E.
CHIEF OF SECTION
E. J. Brown P.E. 7/1/68
PROJECT ENGINEER
Frank Barrella P.E. 7-1-68
CHIEF OF DIVISION

CITY OF NEW YORK
BUREAU OF WATER POLLUTION CONTROL
DIVISION OF PLANT DESIGN
P.W. 164 NORTH RIVER WATER POLLUTION CONTROL PROJECT

CONTRACT NO. 1
SOUTH BRANCH INTERCEPTING SEWER - BANK ST. TO W. 50TH ST.
REGULATOR N-36 TWELFTH AVE. AT W. 46TH ST.
PLANS AND SECTIONS

DATE
SHEET 63 OF 107

27" x 40"

NYC 9/11 Public Portal Document
NYC-WTC_0001165486